


PROFIL

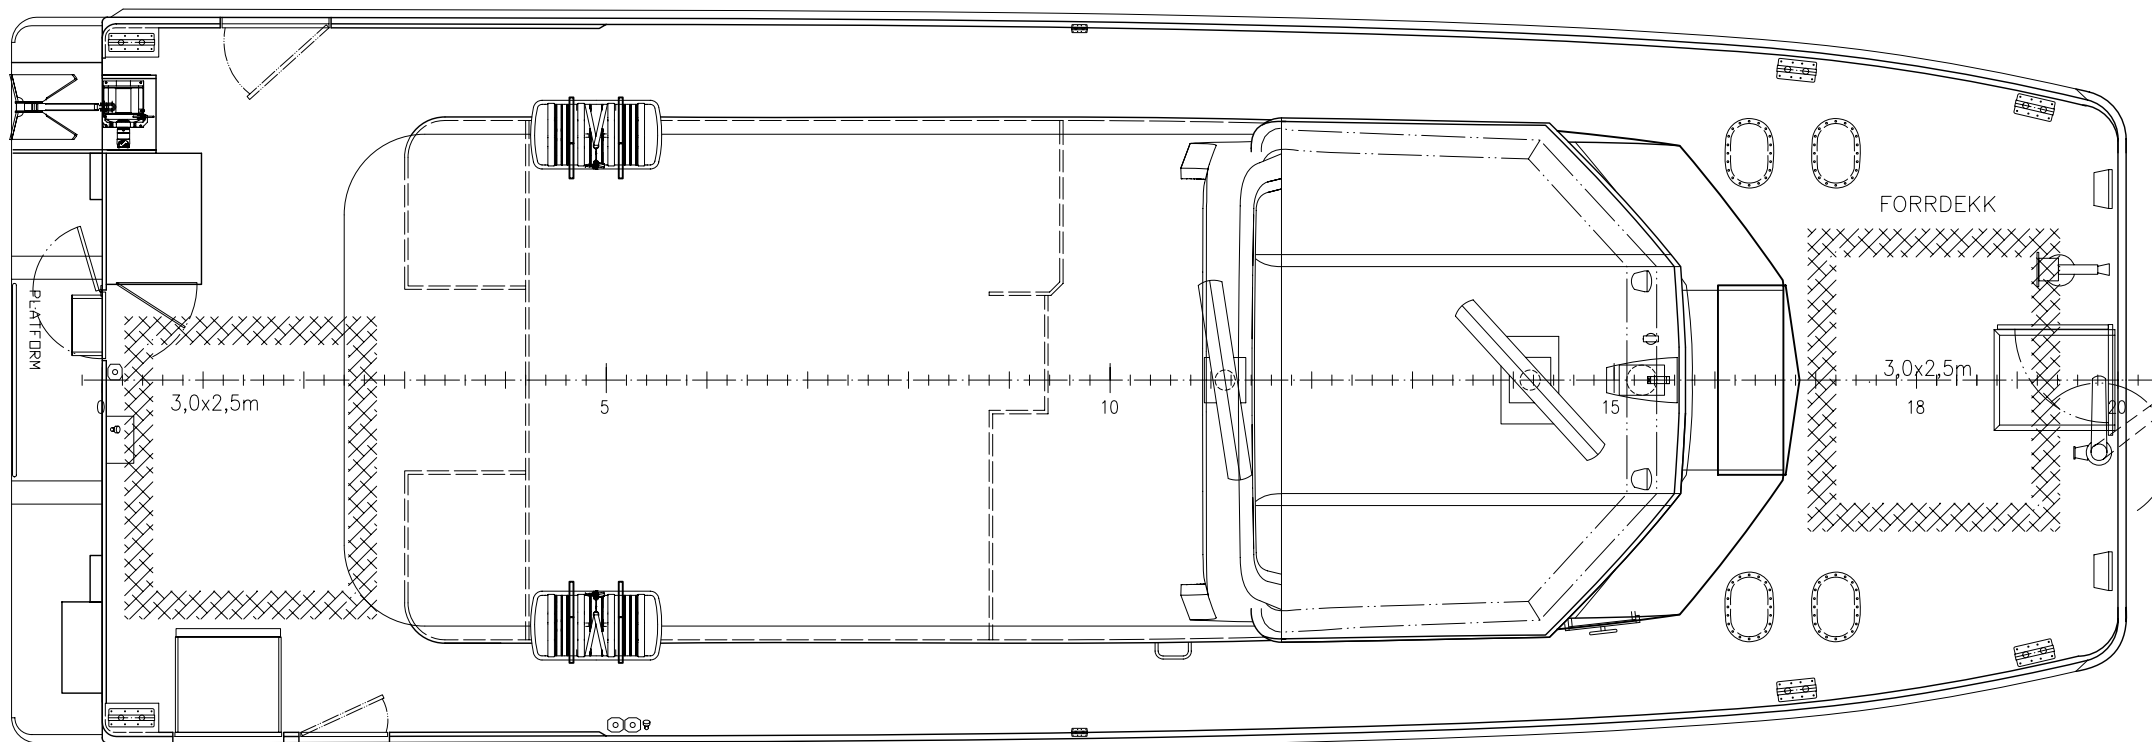

UTVENDIGE DEKK

HOVED DIMENSJONER:	
Lengde o.a.	20,90 m
Lengde p.p./vl	19,05 m
Bredde o.a.	7,20 m
Dybde til h-dekk	2,50 m
Dypgang	0,70 m
Passengers	11
Fartsområde	4

This drawing and the design is our property and must not be disclosed to any third part without permission.

Date	01.02.2011	Drawn	BR	Traced		Scale	1:75
Checked		Stand.check.		Approved			

CAD system
AUTOCAD R14

Proj.method
Br, Aa AS
N-6829 Hyen, NORWAY
Tel. +47 57868700
braa@braa.no - www.braa.no

Title
General Arrangement
External

Project/Vessel
Rødne

Drawing no.
264 - 101 - 6489 - T - 6

Repl. for
Repl. by

Rev.	Om råde	Dato	Beskrivelse	Laget av	Kontr.	Godkj.
6		11.10.11	AS BUILT	TAA		BR
5		06.05.11	ENDRET ETTER ANVISNING FRA RØDNE 06.05.11	BR		BR
4		20.04.11	ENDRET ETTER ANVISNING FRA RØDNE 19.04.11	BR		BR
3		17.11.10	OPPDATERT	BR		BR
2		12.11.10	ENDRET ETTER ØNSKE FRA RØDNE 10.11.2010	BR		BR